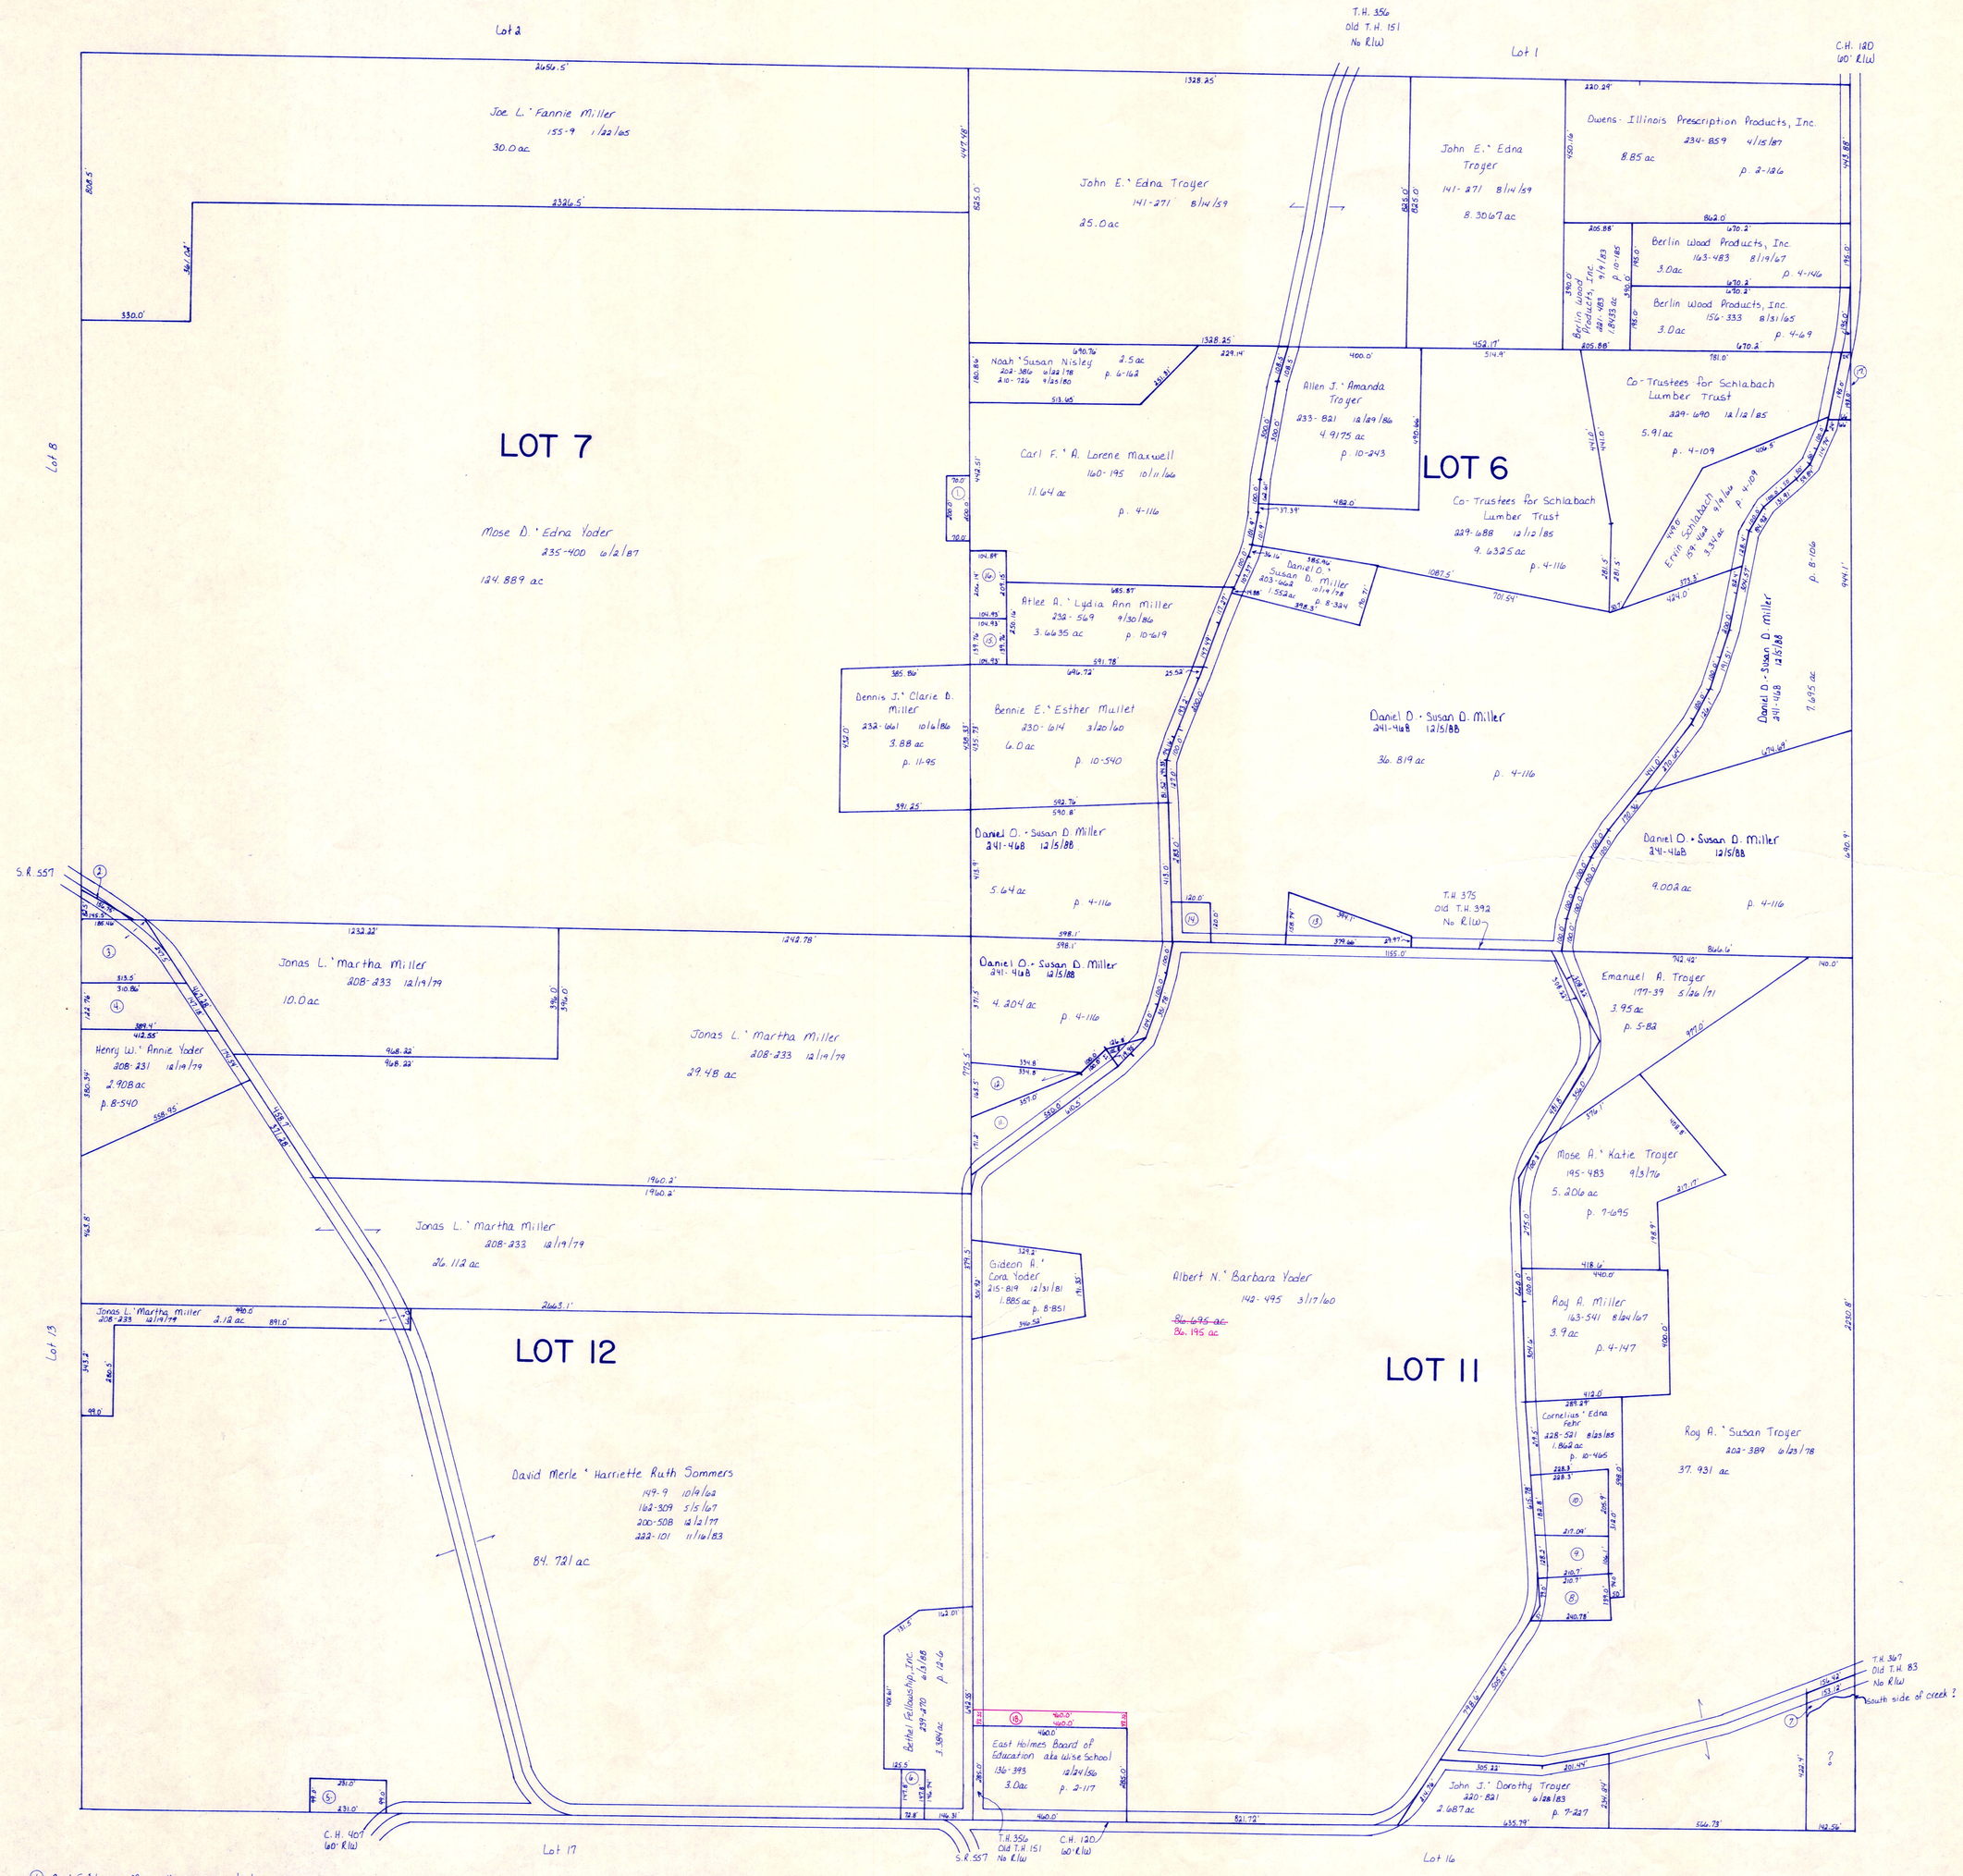

1. Carl F. & Lorene Maxwell 202-384 6/22/87 .321 ac p. 6-162
2. Andy A. & Bertha Troyer 214-407 8/31/81 .4 ac
3. Andy A. & Bertha Troyer 214-407 8/31/81 1.0 ac
4. Andy A. & Bertha Troyer 214-407 8/31/81 1.0 ac
5. John A. & Joanna Jane Yoder 129-153 12/5/54, 218-68 9/3/82 .525 ac
6. Bethel Fellowship, Inc. 241-141 11/4/88 .25 ac
7. Roy A. & Susan Troyer 202-389 6/23/78 S.F.T.
8. Cornelius & Edna Fehr 207-329 9/20/79 .644 ac p. 8-489
9. Cornelius & Edna Fehr 179-290 2/14/72 .5781 ac p. 5-118
10. ~~Berlin Castings, Inc. 242-995 4/4/89~~ Bret Deffenbaugh, Inc. 245-816 2/26/91 ~~Pressweld, Inc. 233-816 12/29/86~~ .9919 ac p. 8-489
11. Reuben A. & Esta Yoder 239-540 7/1/88 1.03 ac p. 3-58 B
12. Reuben A. & Esta Yoder 239-540 7/1/88 .716 ac p. 4-98
13. Daniel D. & Susan D. Miller 241-468 12/5/88 .819 ac p. 10-227
14. Warner B. & Edna Maxwell 108-128 12/19/38, 125-284 4/14/51 See card
15. Atlee A. & Lydia Ann Miller 232-569 9/30/86 .3365 ac p. 10-619
16. Mose D. & Edna Yoder 235-400 6/2/87 .5 ac p. 6-162
17. Jeder, Inc. 241-767 12/29/88 .09 ac p. 4-116
18. East Holmes Board of Education 244-546 8/31/89 .5 ac p. 12-285

T-9, R-6, 4th. Qtr.
Lots 6, 7, 11, 12
BERLIN TWP.

SCALE: 1" = 200'

LET IT BE KNOWN, THIS MAP HAS BEEN PREPARED AS A REFERENCE GUIDE TO PROPERTY OWNERSHIP. WE BELIEVE THIS INFORMATION TO BE CORRECT AND CURRENT, HOWEVER, IT IS NOT INTENDED FOR ANY LEGAL USE, WHETHER IT BE IN SALES, TRANSFERS, TRADES, LEASES OF ANY TYPE, ETC., AND DO NOT ACCEPT RESPONSIBILITY FOR ERRORS OF ANY NATURE OR OMISSIONS CONTAINED HEREIN.