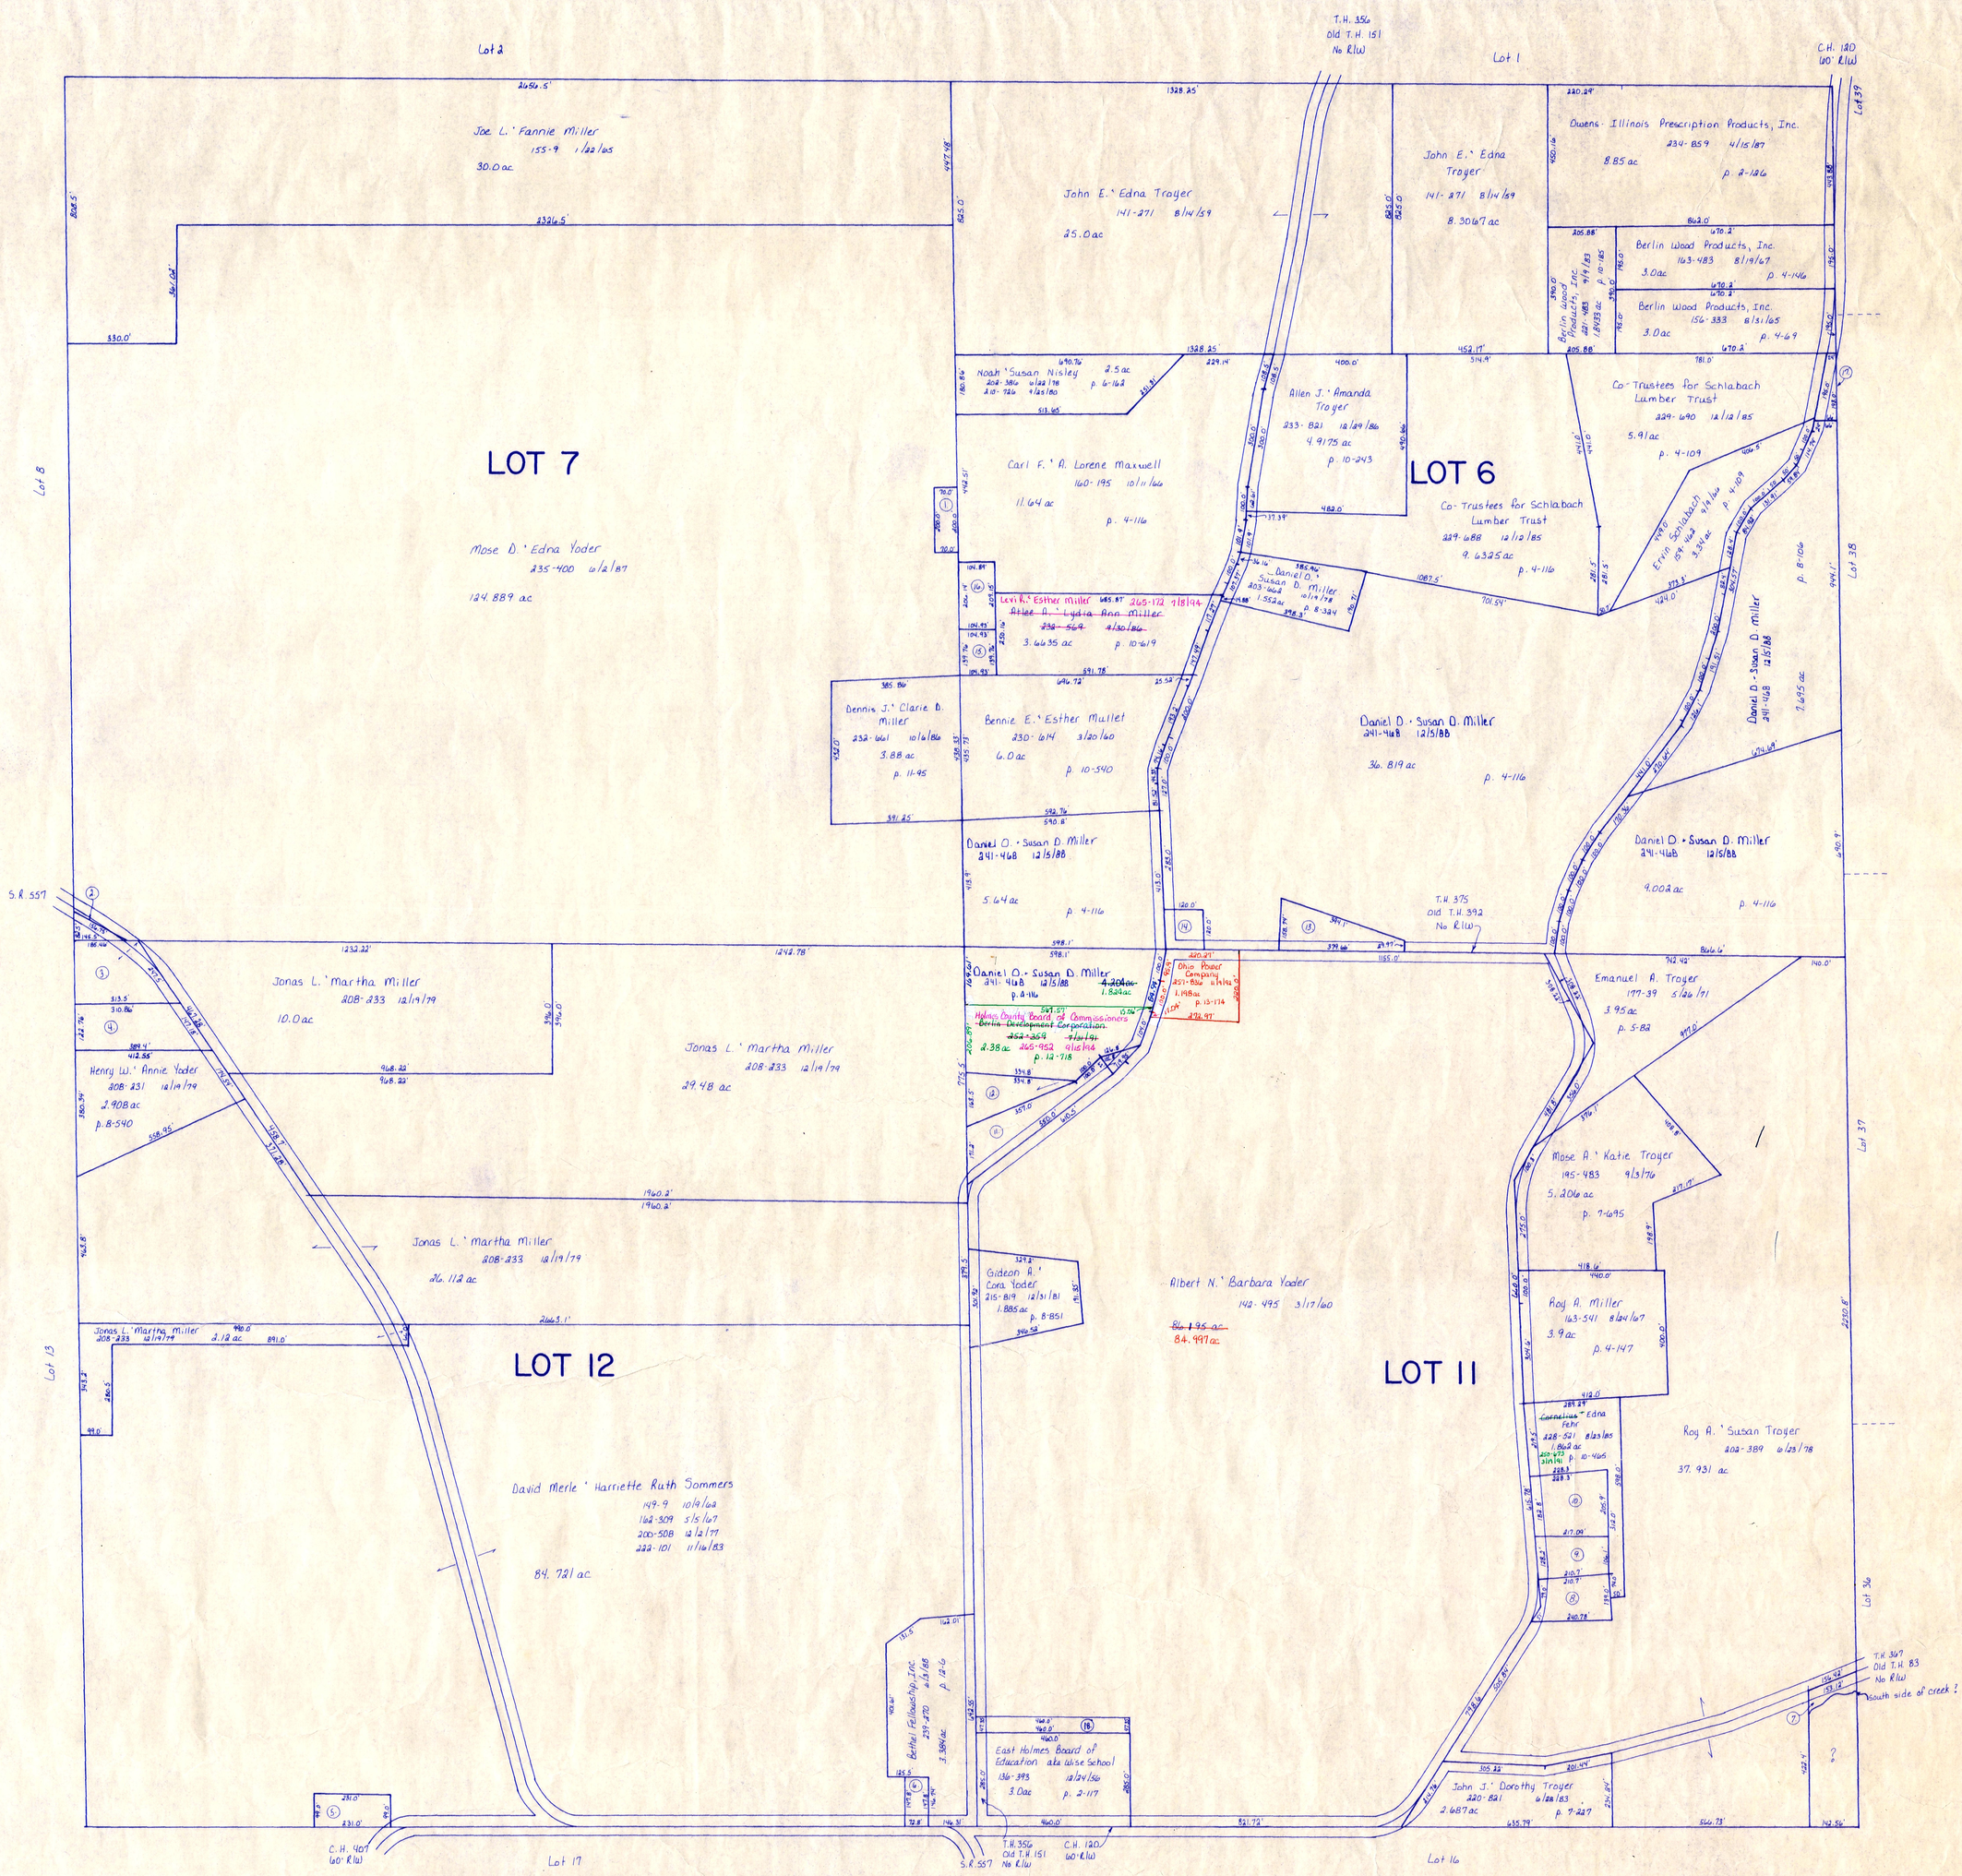

1. ~~Carl F. & Lorene Maxwell 202-384 6/22/67 .321 ac p. 6-162~~
2. ~~Andy A. & Bertha Troyer 214-407 8/31/81 .4 ac~~
3. ~~Andy A. & Bertha Troyer 214-407 8/31/81 1.0 ac~~
4. ~~Andy A. & Bertha Troyer 214-407 8/31/81 1.0 ac~~
5. ~~John A. & Joanna Jane Yoder 189-153 12/5/64, 218-68 4/3/82 .525 ac~~
6. ~~Bethel Fellowship, Inc. 241-141 11/4/88 .25 ac~~
7. ~~Roy A. & Susan Troyer 203-389 6/28/78 S.F.T.~~
8. ~~Cornelius & Edna Fehr 207-339 7/20/79 .644 ac p. 8-489~~
9. ~~Cornelius & Edna Fehr 179-290 2/14/78 .578 ac p. 5-118~~
10. ~~Bret Deffenbaugh, Inc. 245-405 11/20/89 .9919 ac p. 8-489~~
11. ~~Reuben A. & Esta Yoder 239-540 7/1/88 1.03 ac p. 3-58 B~~
12. ~~Gideon A. & Cora Yoder 251-383 5/14/91~~
13. ~~Reuben A. & Esta Yoder 239-540 7/1/88 .716 ac p. 4-98~~
14. ~~Daniel D. & Susan D. Miller 241-468 12/5/88 .819 ac p. 10-237~~
15. ~~Warner B. & Edna Maxwell 108-128 12/19/38, 185-284 4/14/51 see card~~
16. ~~Atlee A. & Lydia Ann Miller 238-569 4/30/86 .3365 ac p. 10-619~~
17. ~~Mose D. & Edna Yoder 235-400 6/2/87 .5 ac p. 6-162~~
18. ~~Jeder, Inc. 241-769 12/29/88 .09 ac p. 4-116~~
19. ~~East Holmes Board of Education 244-546 8/3/84 .5 ac p. 12-286~~

For numbered parcels see folder

T-9, R-6, 4th. Qtr.
Lots 6, 7, 11, 12
BERLIN TWP.

SCALE: 1" = 200'

LET IT BE KNOWN, THIS MAP HAS BEEN PREPARED AS A REFERENCE GUIDE TO PROPERTY OWNERSHIP. WE BELIEVE THIS INFORMATION TO BE CORRECT AND CURRENT, HOWEVER, IT IS NOT INTENDED FOR ANY LEGAL USE, WHETHER IT BE IN SALES, TRANSFERS, TRADES, LEASES OF ANY TYPE, ETC. AND DO NOT ACCEPT RESPONSIBILITY FOR ERRORS OF ANY NATURE OR OMISSIONS CONTAINED HEREIN.