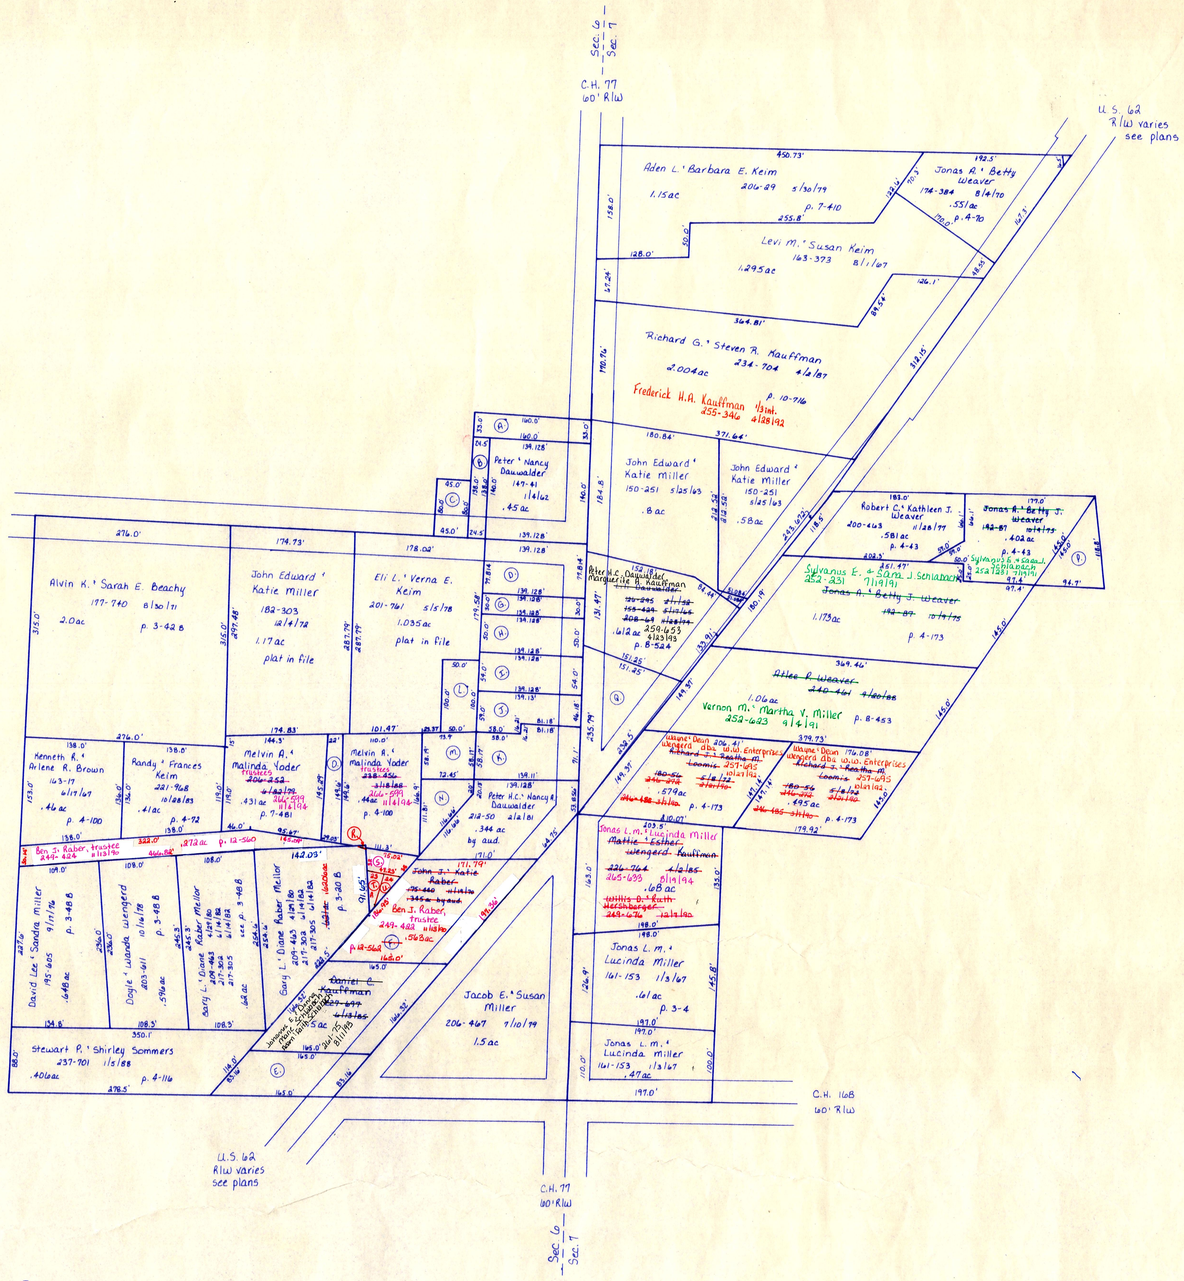

(A) Peter & Nancy Dauwalder 147-41 1/4/62 .12ac

(B) Peter & Nancy Dauwalder 147-41 1/4/62 .076ac

(C) Peter Dauwalder 184-739 8/15/73 .08ac

(D) Eli L. & Verna E. Keim 201-761 5/5/78 .245ac

(E) Johannes E.? Anna Marie Schlabach; Adam & Faith Schlabach 261-75 8/11/93
~~Daniel E. Kauffman 227-677 6/13/85~~ .25ac

(F) ~~John J. & Katie Raber 175-440 11/11/70 .229ac~~

(G) Elmer & Amanda Mast 188-800 9/24/74 .095ac

(H) Eli L. & Verna E. Keim 201-761 5/5/78 .172ac

(I) ~~Amanda J.~~ Verna J. Gingerich ~~247-190~~ 5/14/90
163-127 7/6/67
259-808 2/3/93 .172ac

(J) Roy J. & Ada M. Kauffman 193-288 3/2/76 .153ac p. 5-174

(K) Roy J. & Ada Mae Kauffman 204-63 11/17/78 .216ac p. 5-174
~~4.4ac~~ 255-1051 6/25/92

(L) Raymond J. & Esther J. Kaufman 203-135 8/24/78 .115ac p. 8-186

(M) Raymond J. & Esther Kauffman 210-46 7/17/80 .097ac p. 8-627

(N) Peter H.C. & Nancy A. Dauwalder 212-50 2/3/81 .153ac

(O) Melvin A. & Malinda Yoder, ~~238-456 3/16/88~~ trustees 206-599 11/6/90 .085ac p. 4-100
Sylvanus E. & Saraa J. Schlabach 252-231 7/19/91

(P) ~~Jonas A. & Betty J. Weaver 192-87 12/4/75~~ .13ac p. 7-54

(Q) Peter H.C. & Nancy Ann Dauwalder 192-816 10/26/75 .341ac p. 7-526

(R) Melvin A. & Malinda Yoder, ~~249-430 11/13/90~~ trustees 206-599 11/6/90 .0004ac p. 12-561

(S) Ben J. Raber, trustee 249-424 11/13/90 .045ac p. 12-561

(T) Gary L. & Diane Mellor 249-428 11/13/90 .017ac p. 12-561

(U) Ben J. Raber, trustee 249-424 11/13/90 .013ac p. 12-561

N

BUNKER HILL

T-9, R-5, Sec. 6 & 7
BERLIN TWP.

SCALE: 1" = 100'

LET IT BE KNOWN, THIS MAP HAS BEEN PREPARE
AS A REFERENCE GUIDE TO PROPERTY OWNERSHI
WE BELIEVE THIS INFORMATION TO BE CORREC
AND CURRENT, HOWEVER, IT IS NOT INTENDE
FOR ANY LEGAL USE, WHETHER IT BE IN SALES
TRANSFERS, TRADES, LEASES OF ANY TYPE, ETC
AND DO NOT ACCEPT RESPONSIBILITY FOR ERRORS
OF ANY NATURE OR OMISSIONS CONTAINED HEREIN

B-19A