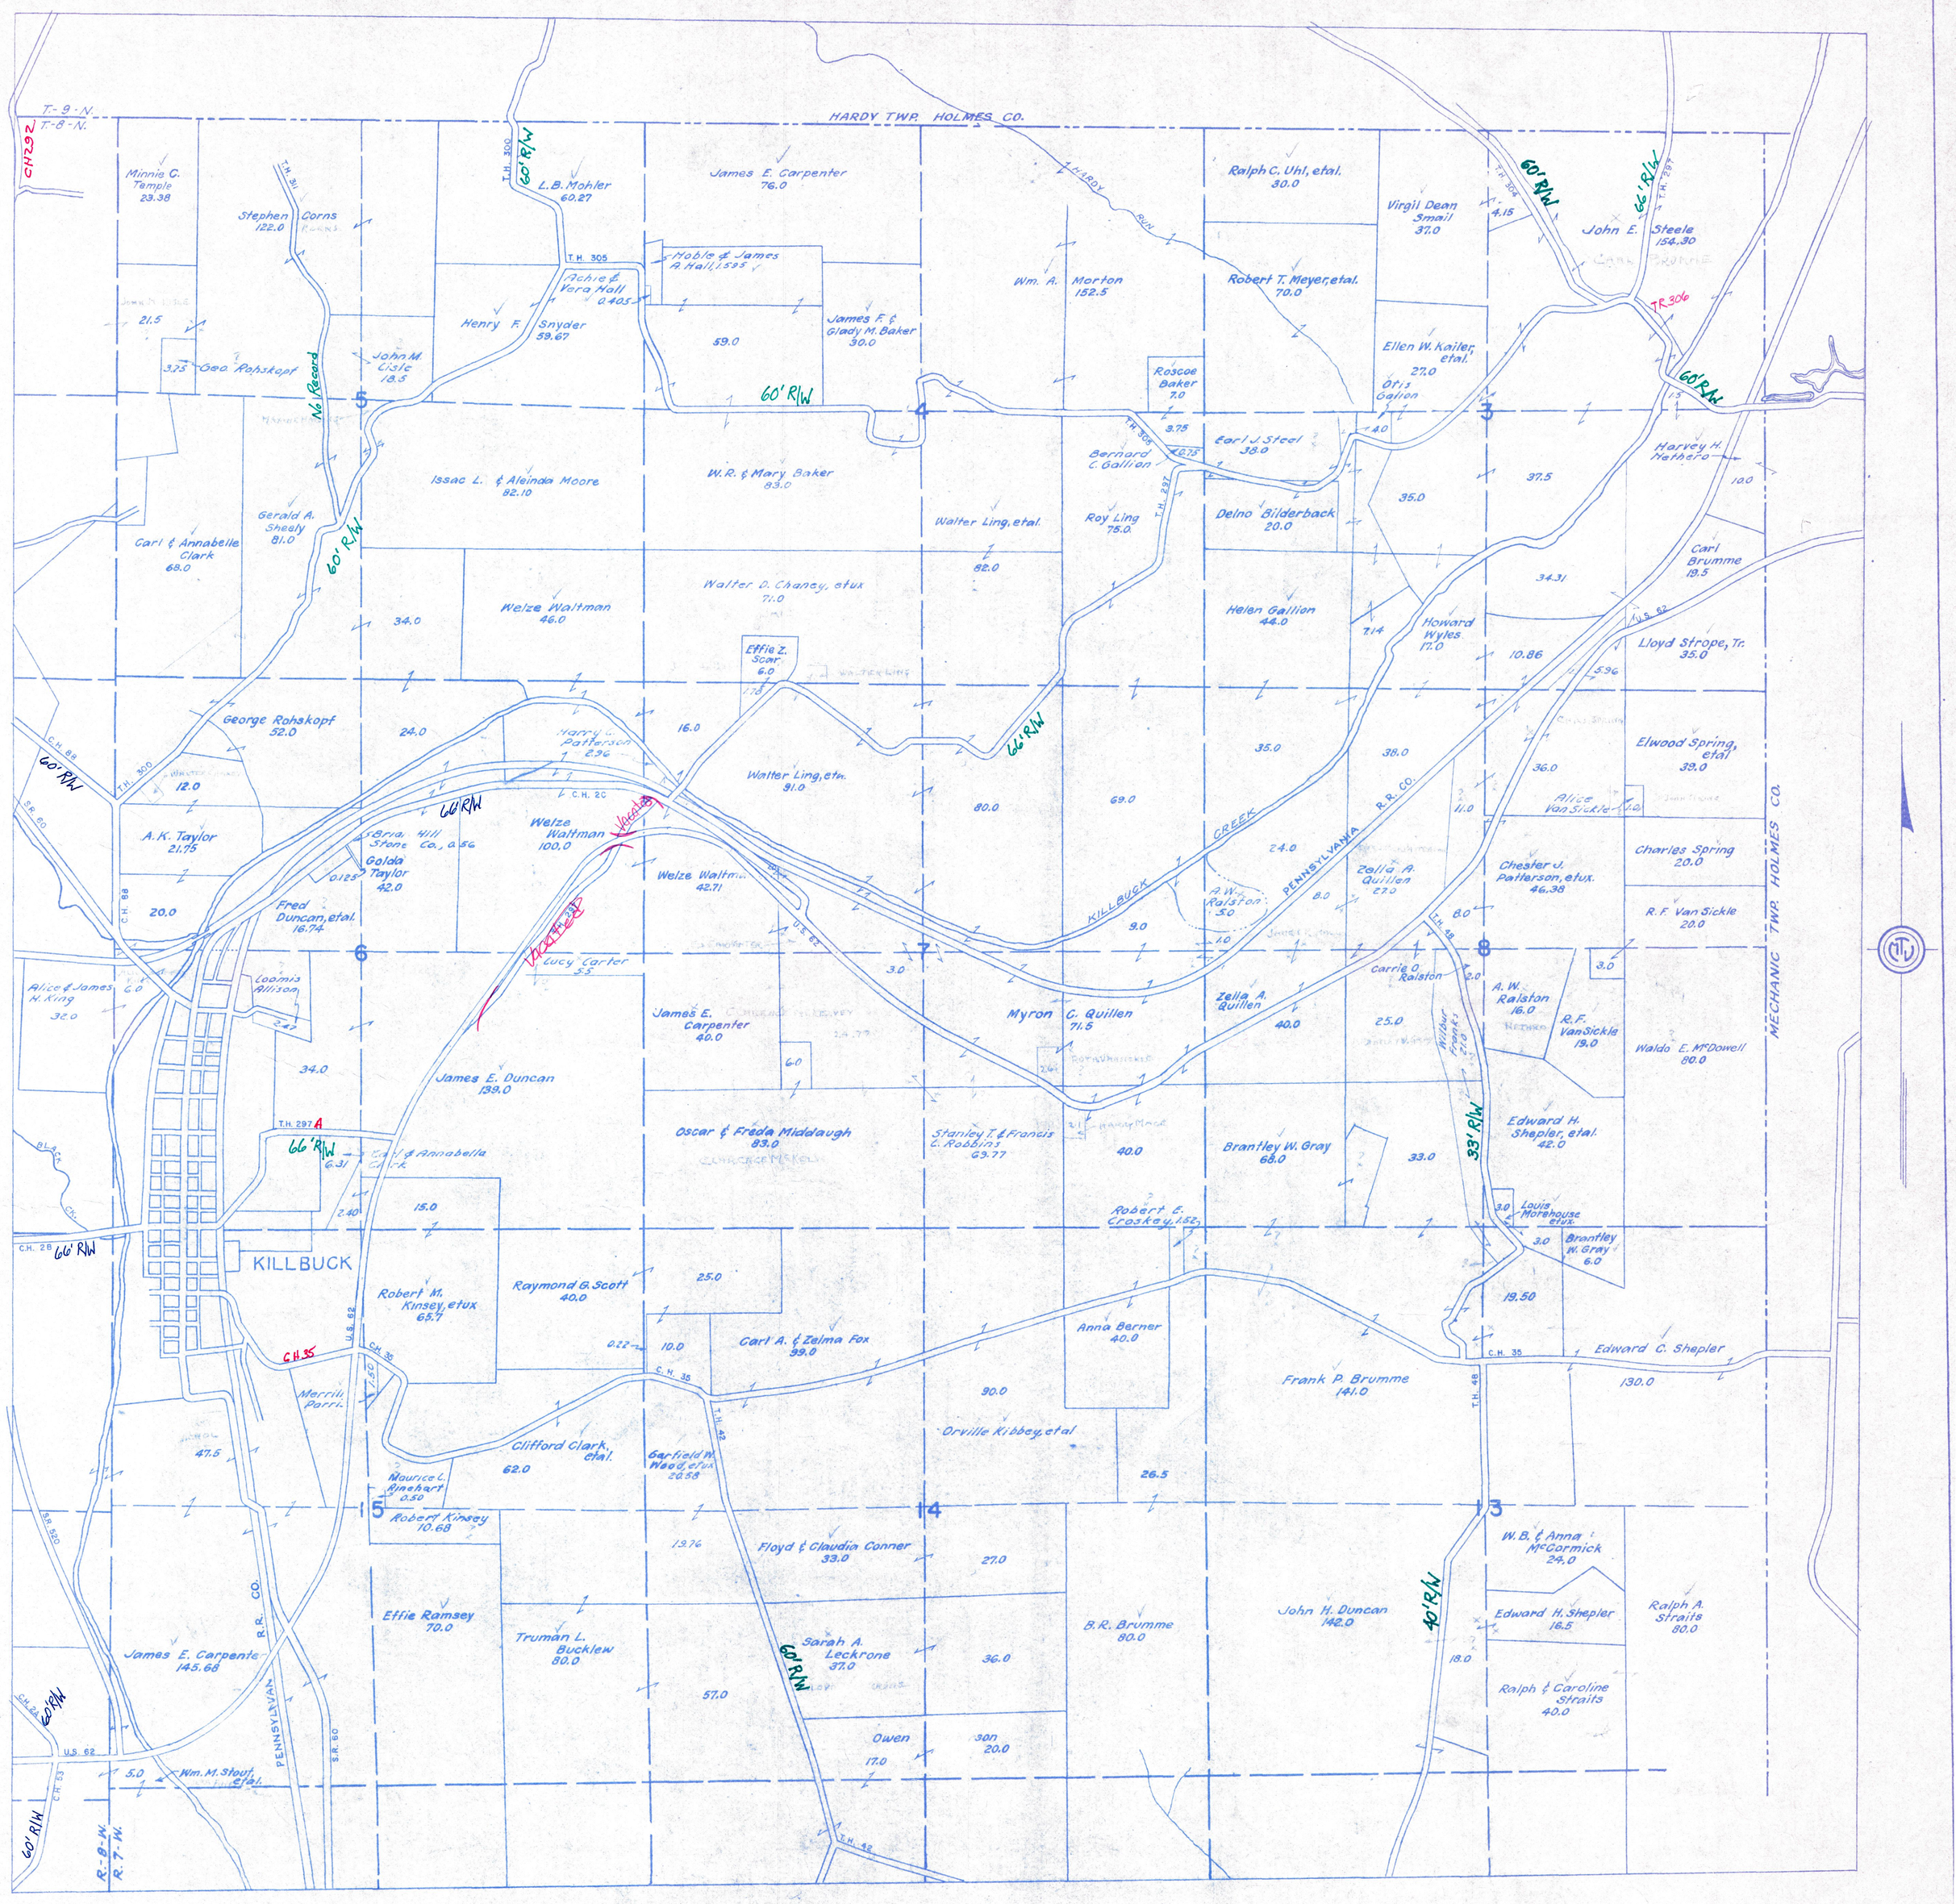


# HOLMES COUNTY
# KILLBUCK TOWNSHIP
## N.E. PART

SCALE: 1" = 660'

**Base map dated circa 1947**
**Date unknown for items marked in RED**

KARL SNYDER - COUNTY ENGINEER
MYRON T. JONES - REG. PROF. ENGR. & SURV.

JUNE 1947