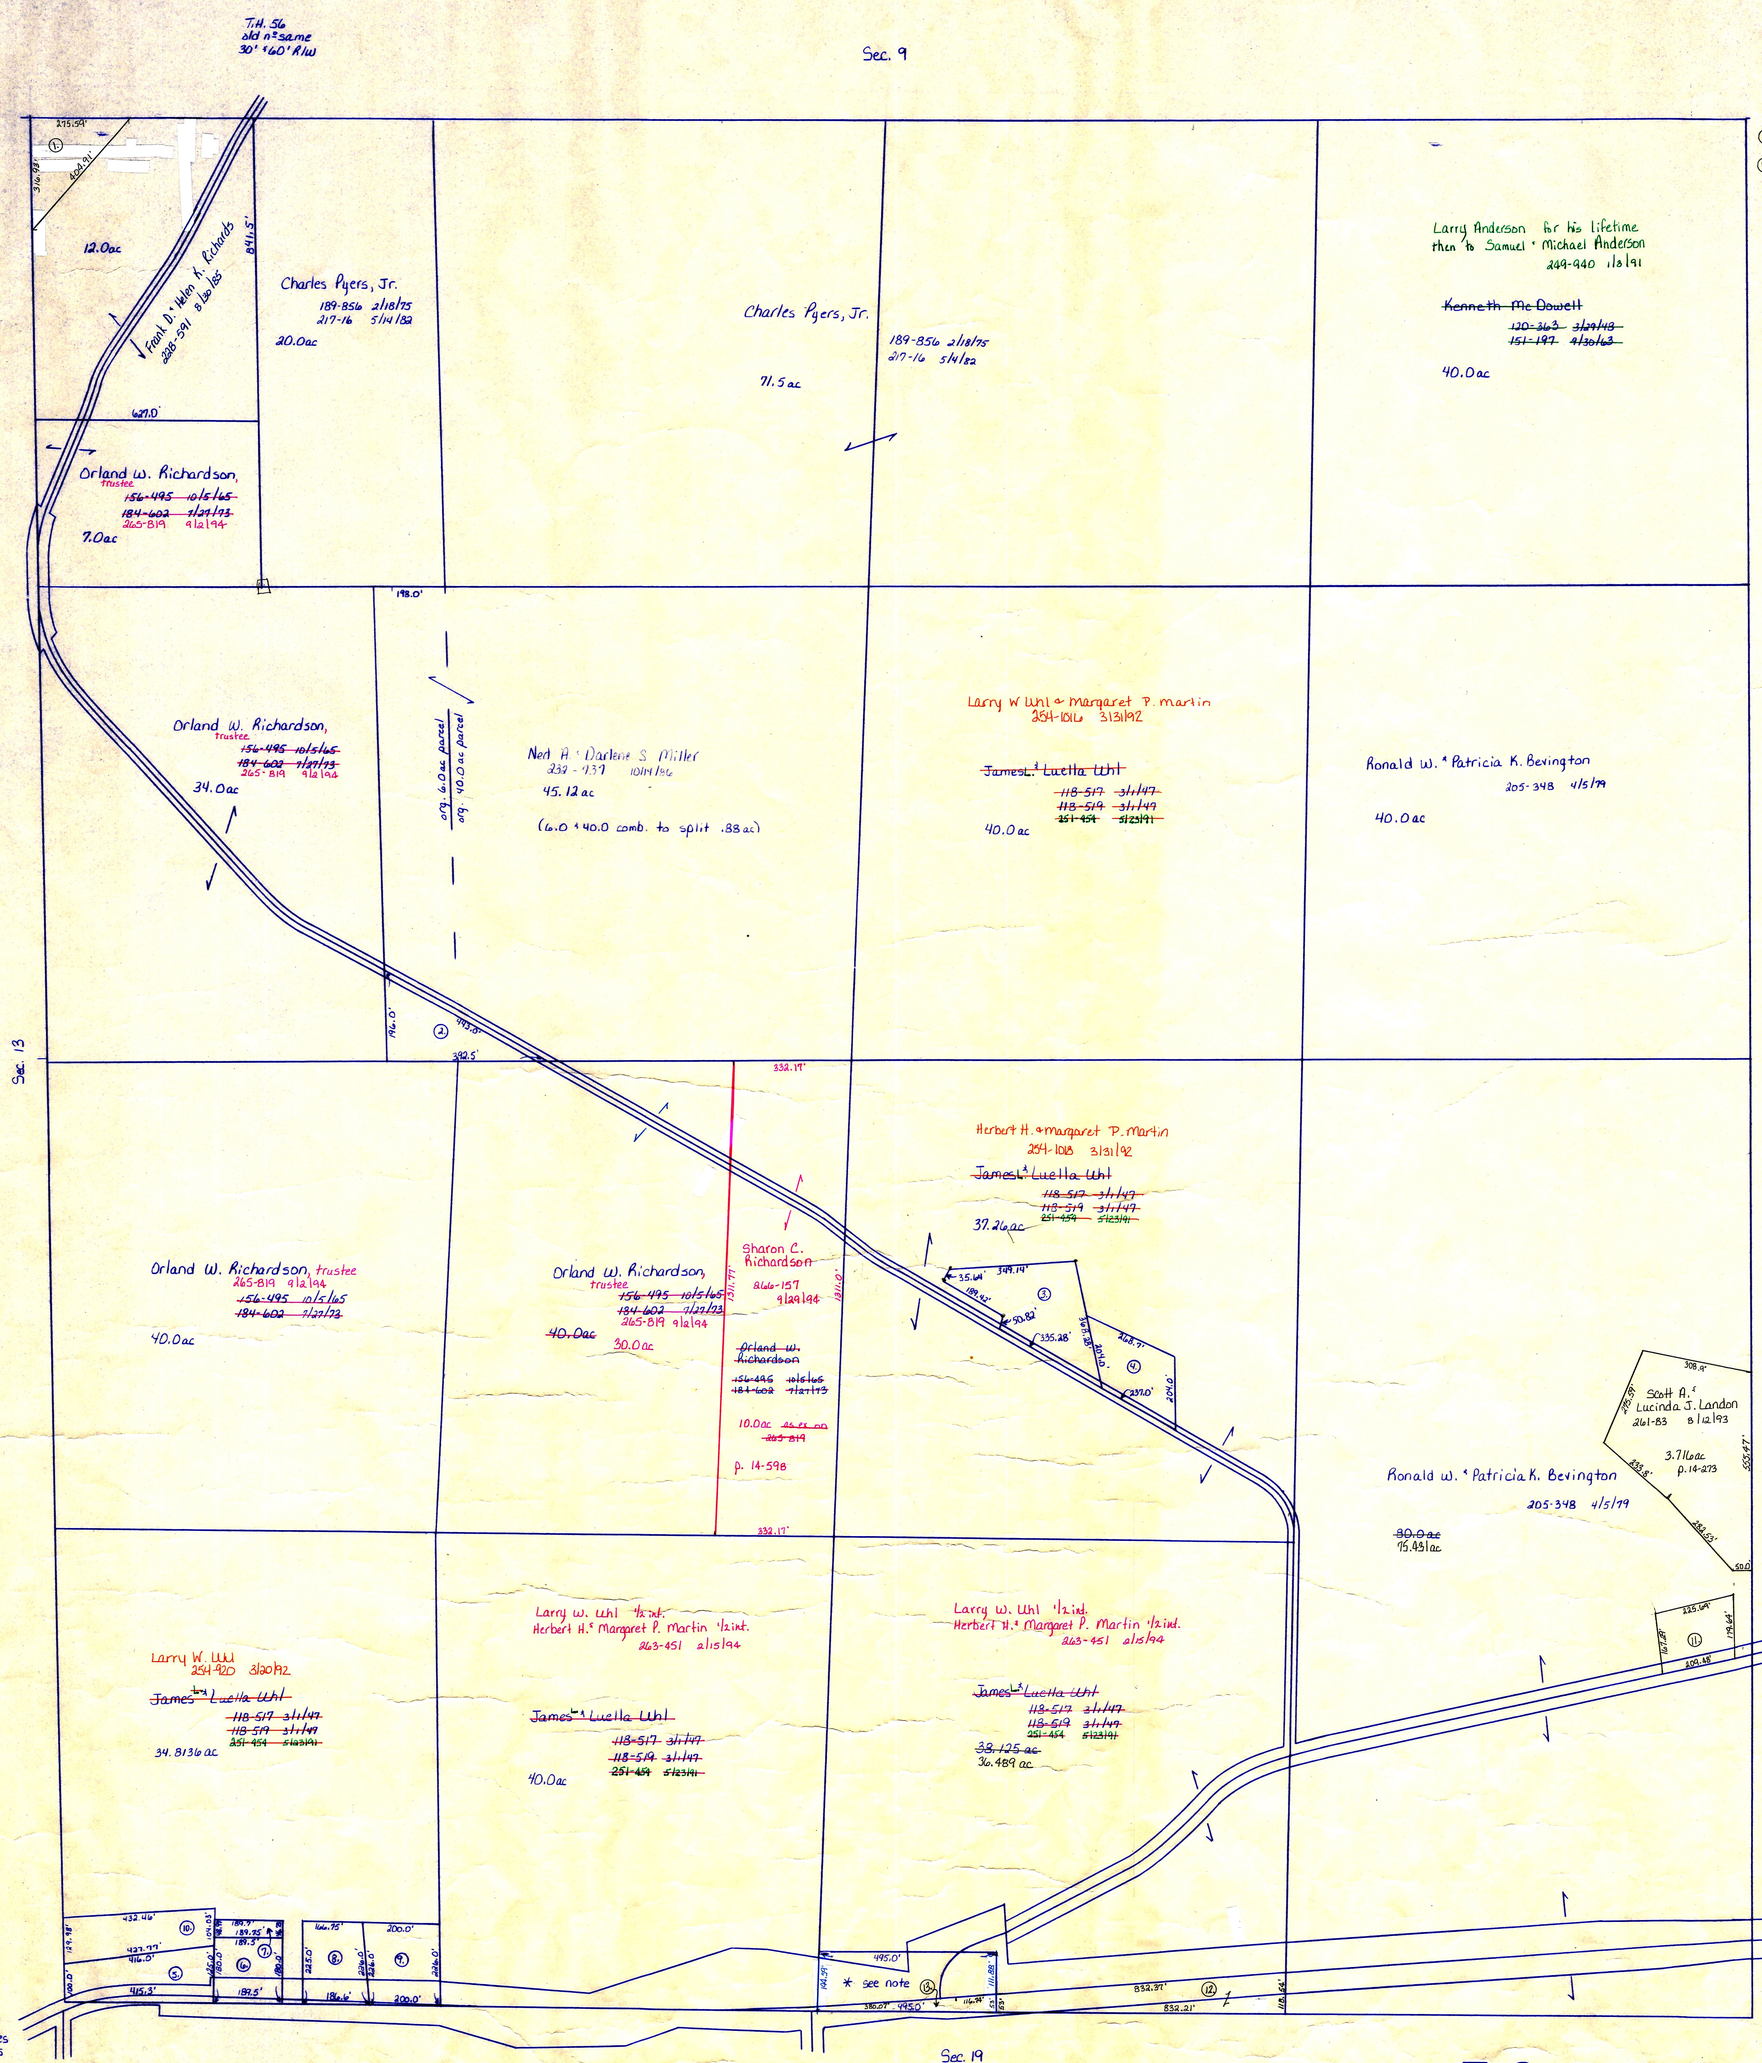

(a) David L.ᵃ Patty Lou Masters 262-884 12/29/93 1.636ac p. 14-399

(b) David L.ᵃ Patty Lou Masters 262-886 12/29/93 .4ac p. 14-399
(see note * below)

* Bradford Middaugh, 33-156 11/21/1890, is the last deeded owner for 30 rods x 10 rods parcel. (~~1.875 ac~~ 1.375ac). This parcel is excepted on Uhl's deeds 118-517 & 519, however, it is not subtracted from his taxable acreage.
A piece of this tract was Q.C. from Uhl to Masters in 262-886 12/29/93.

1. Frank D.ᵃ Helen K. Richards 259-984 5/17/93 1.0ac p. 14-208
   ~~Helen Kursell 224-376 11/13/85~~
2. Orland W. Richardson, trustee ~~156-495 10/5/65, 184-602 7/27/73~~ 265-819 9/2/94 .88ac
3. Jimmy L.ᵃ Betty L. Eddy 200-430 11/22/77 1.76ac
4. Herbert & Margaret Martin 183-336 3/21/73 .98ac
5. Thomas M. Richards 227-612 1.1ac 6/4/85
6. Andrew Norris & Mary J. Small 253-555 11/22/91 ~~Denver Ray & Louise M. Conner 154-345 11/24/64~~ .78ac
7. Andrew Norris & Mary J. Small 253-555 11/22/91 ~~Denver Ray & Louise M. Conner 232-795 2/15/64~~ .2084ac p. 10-229
8. Kevin S. Martin & Kimberly Hunsberger 219-972 4/4/83 .913ac p. 10-115
9. Robert L.ᵃ Marie D. Lester 247-167 6/25/90 ~~Larry & Mary Marlene Moore 160-333 10/24/66~~ 1.03ac p. 2-95
10. Thomas M. Richards 228-966 10/7/85 1.155ac p. 10-483
11. Lori L. Bevington 261-85 8/12/93 .853ac p. 14-273

T-8, R-8, Sec. 12
KILLBUCK TWP.

scale: 1" = 200'

LET IT BE KNOWN, THIS MAP HAS BEEN PREPARED AS A REFERENCE GUIDE TO PROPERTY OWNERSHIP. WE BELIEVE THIS INFORMATION TO BE CORRECT AND CURRENT; HOWEVER, IT IS NOT INTENDED FOR ANY LEGAL USE, WHETHER IT BE IN SALES, TRANSFERS, TRADES, LEASES OF ANY TYPE, ETC., AND DO NOT ACCEPT RESPONSIBILITY FOR ERRORS OF ANY NATURE OR OMISSIONS CONTAINED HEREIN.

K-8