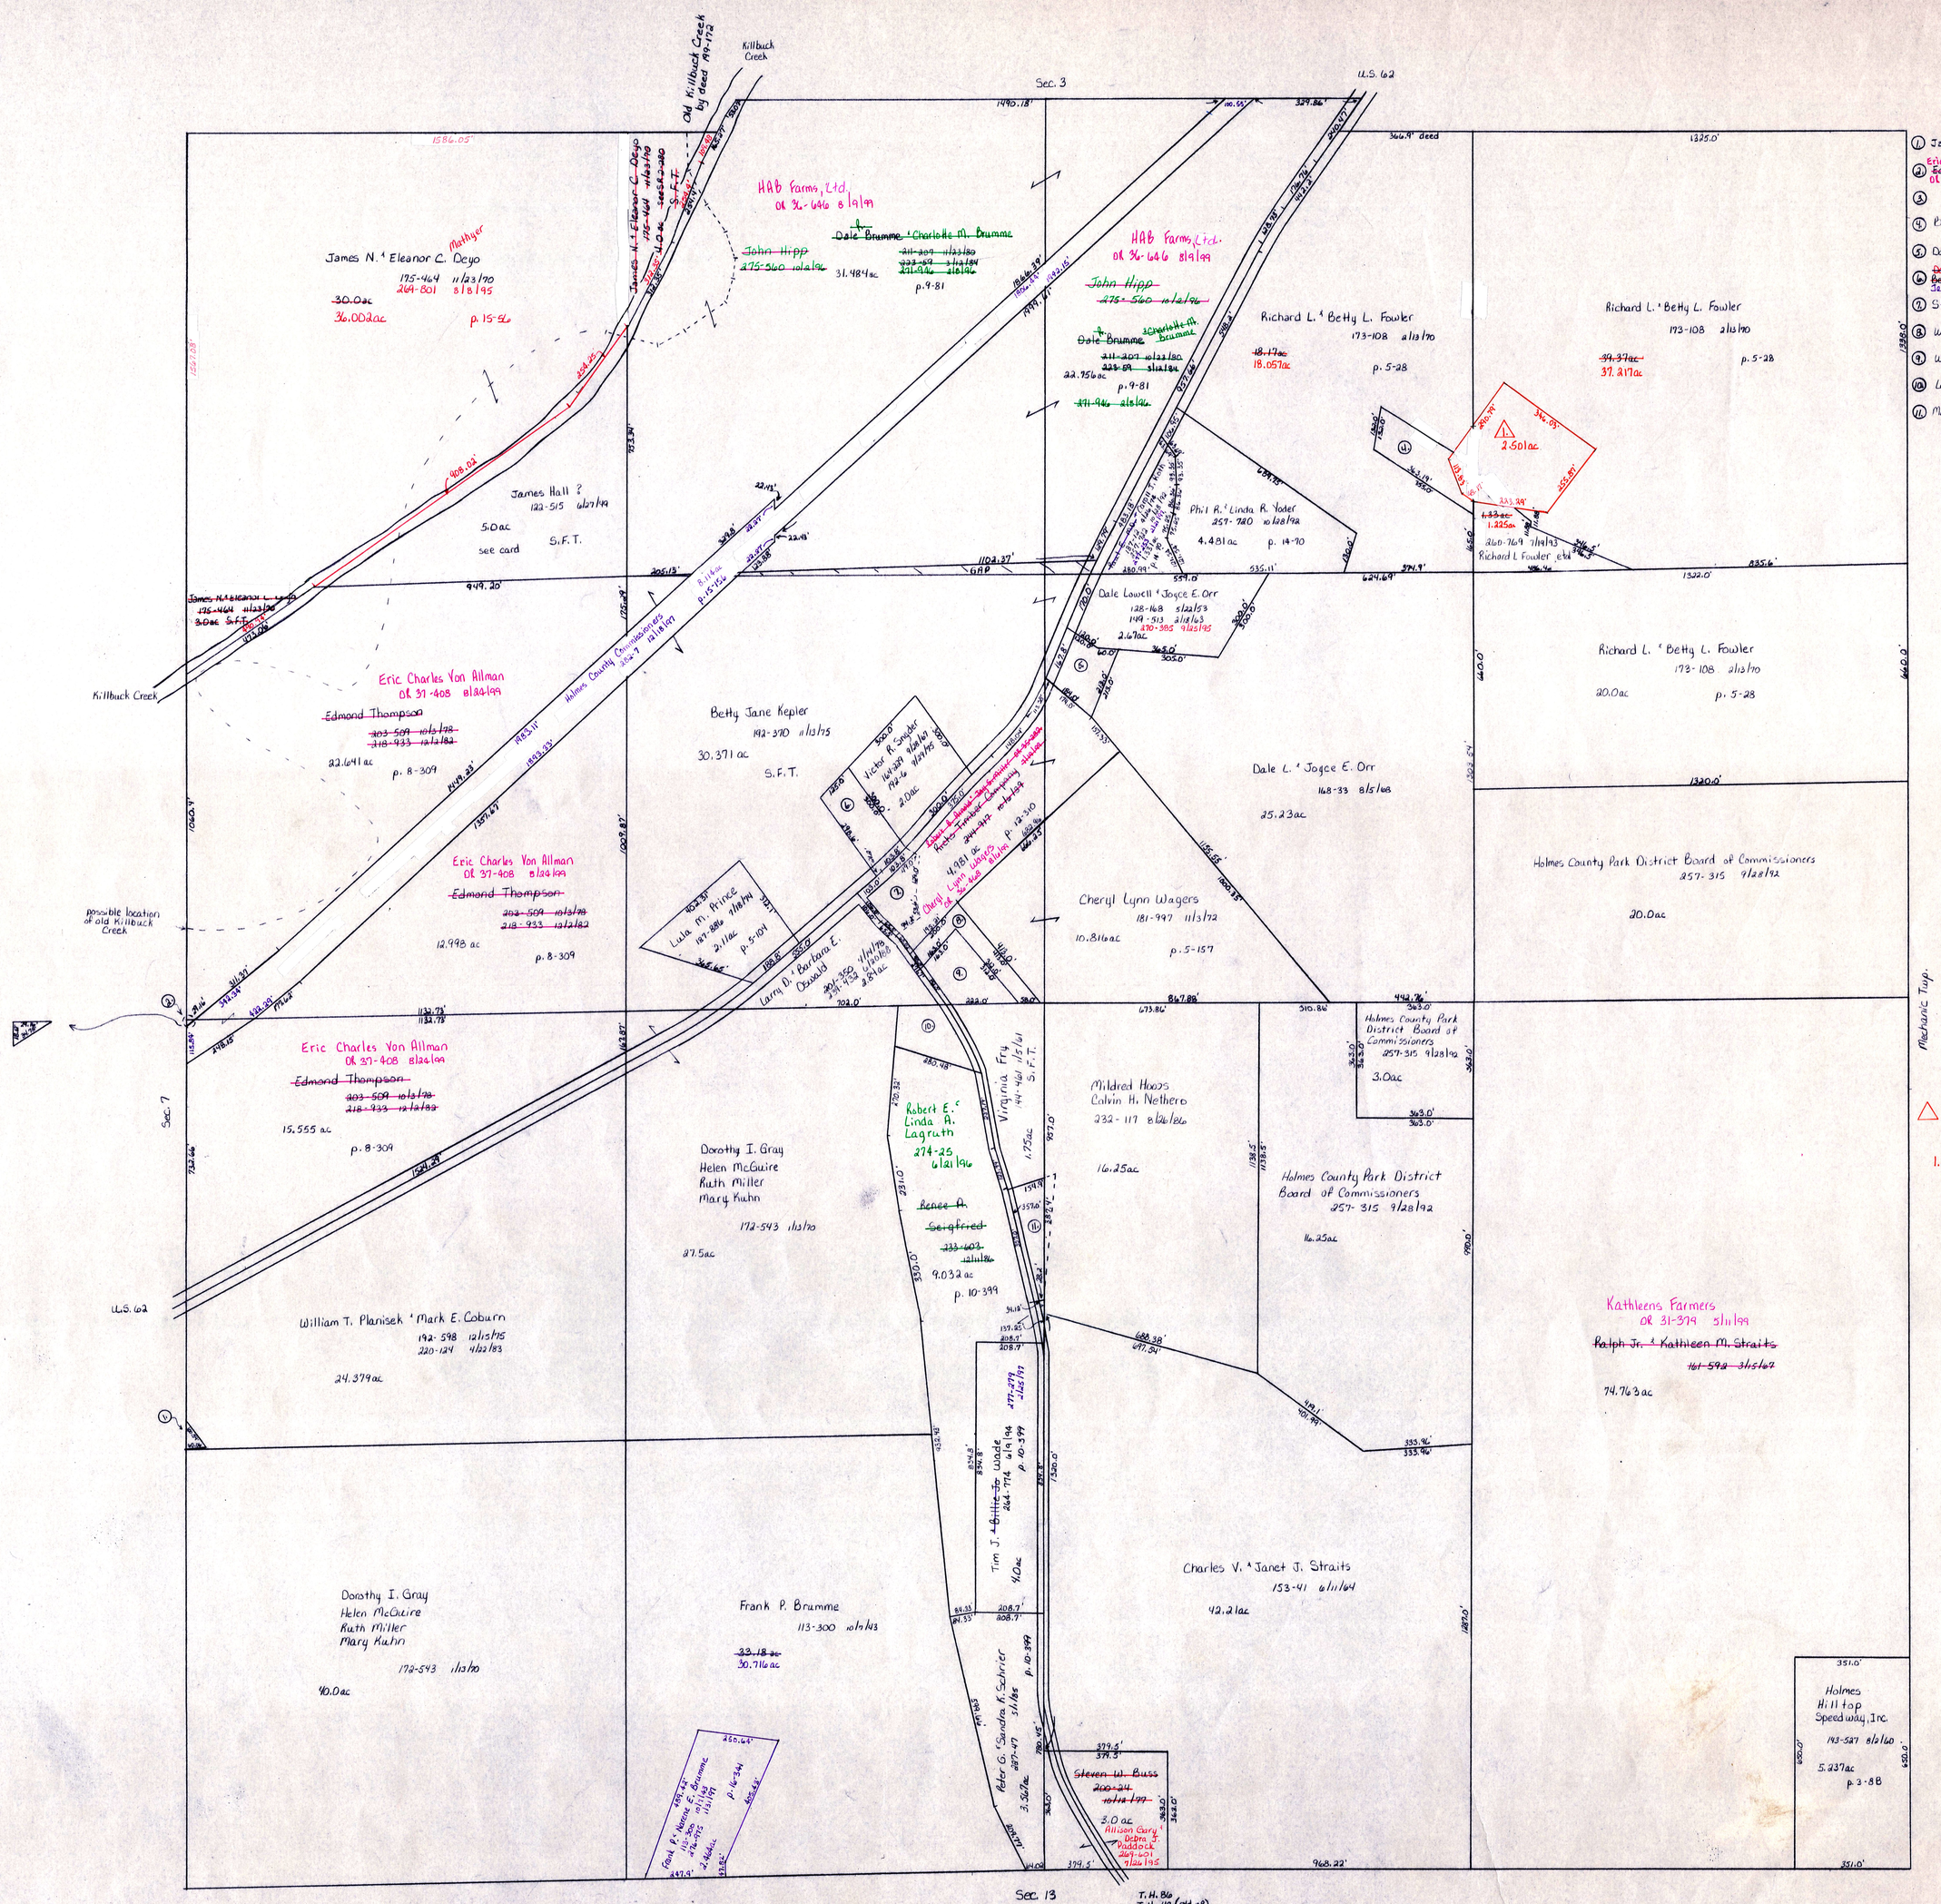

1. James A. & Verna Casey 204-212 12/4/78 .062ac p. 7-433
2. ~~Edmond Thompson~~ ~~203-509 10/3/78~~ ~~218-933 12/2/82~~ Eric Charles Von Allman OR 37-408 8/26/99 .006ac p. 8-309
3.
4. Betty L. Fowler 201-840 10/7/93 ~~1.0ac~~ .87ac p. 10-281
5. Dale L. & Joyce E. Orr 167-793 7/1/68 270-385 9/25/95 .749ac p. 2-128
6. ~~Bernard C. & Bertha L. Gattion 158-551 6/11/60~~ ~~David M. & Clara R. Miller 268-332 6/26/95~~ Jeffrey L. & Roxanne L. Jones 278-391 5/29/97 .84ac
7. State of Ohio .665ac Highway Ease. I-365 8/8/38
8. Wilbert & Alice Butler 141-213 8/3/59 .863ac
9. Wilbert & Alice Butler 141-211 8/3/59 .873ac
10. Larry D. & Barbara E. Oswald 201-530 4/14/78 1.0ac
11. Mavadell G. Arbogast 168-92 9/20/68 178-586 11/5/91 212-972 10/25/93 .74ac p. 5-98

△ R. & R. Fowler Allotment No. 1
PLAT 16-724 PLATTED 5/14/98
1. James A. & Renee L. Mirich OR 8-970 5/14/98

T-8, R-7, Sec. 8
KILLBUCK TWP.

SCALE: 1" = 200'

LET IT BE KNOWN, THIS MAP HAS BEEN PREPARED AS A REFERENCE GUIDE TO PROPERTY OWNERSHIP. WE BELIEVE THIS INFORMATION TO BE CORRECT AND CURRENT, HOWEVER, IT IS NOT INTENDED FOR ANY LEGAL USE, WHETHER IT BE IN SALES, TRANSFERS, TRADES, LEASES OF ANY TYPE, ETC., AND DO NOT ACCEPT RESPONSIBILITY FOR ERRORS OF ANY NATURE OR OMISSIONS CONTAINED HEREIN.

K-29