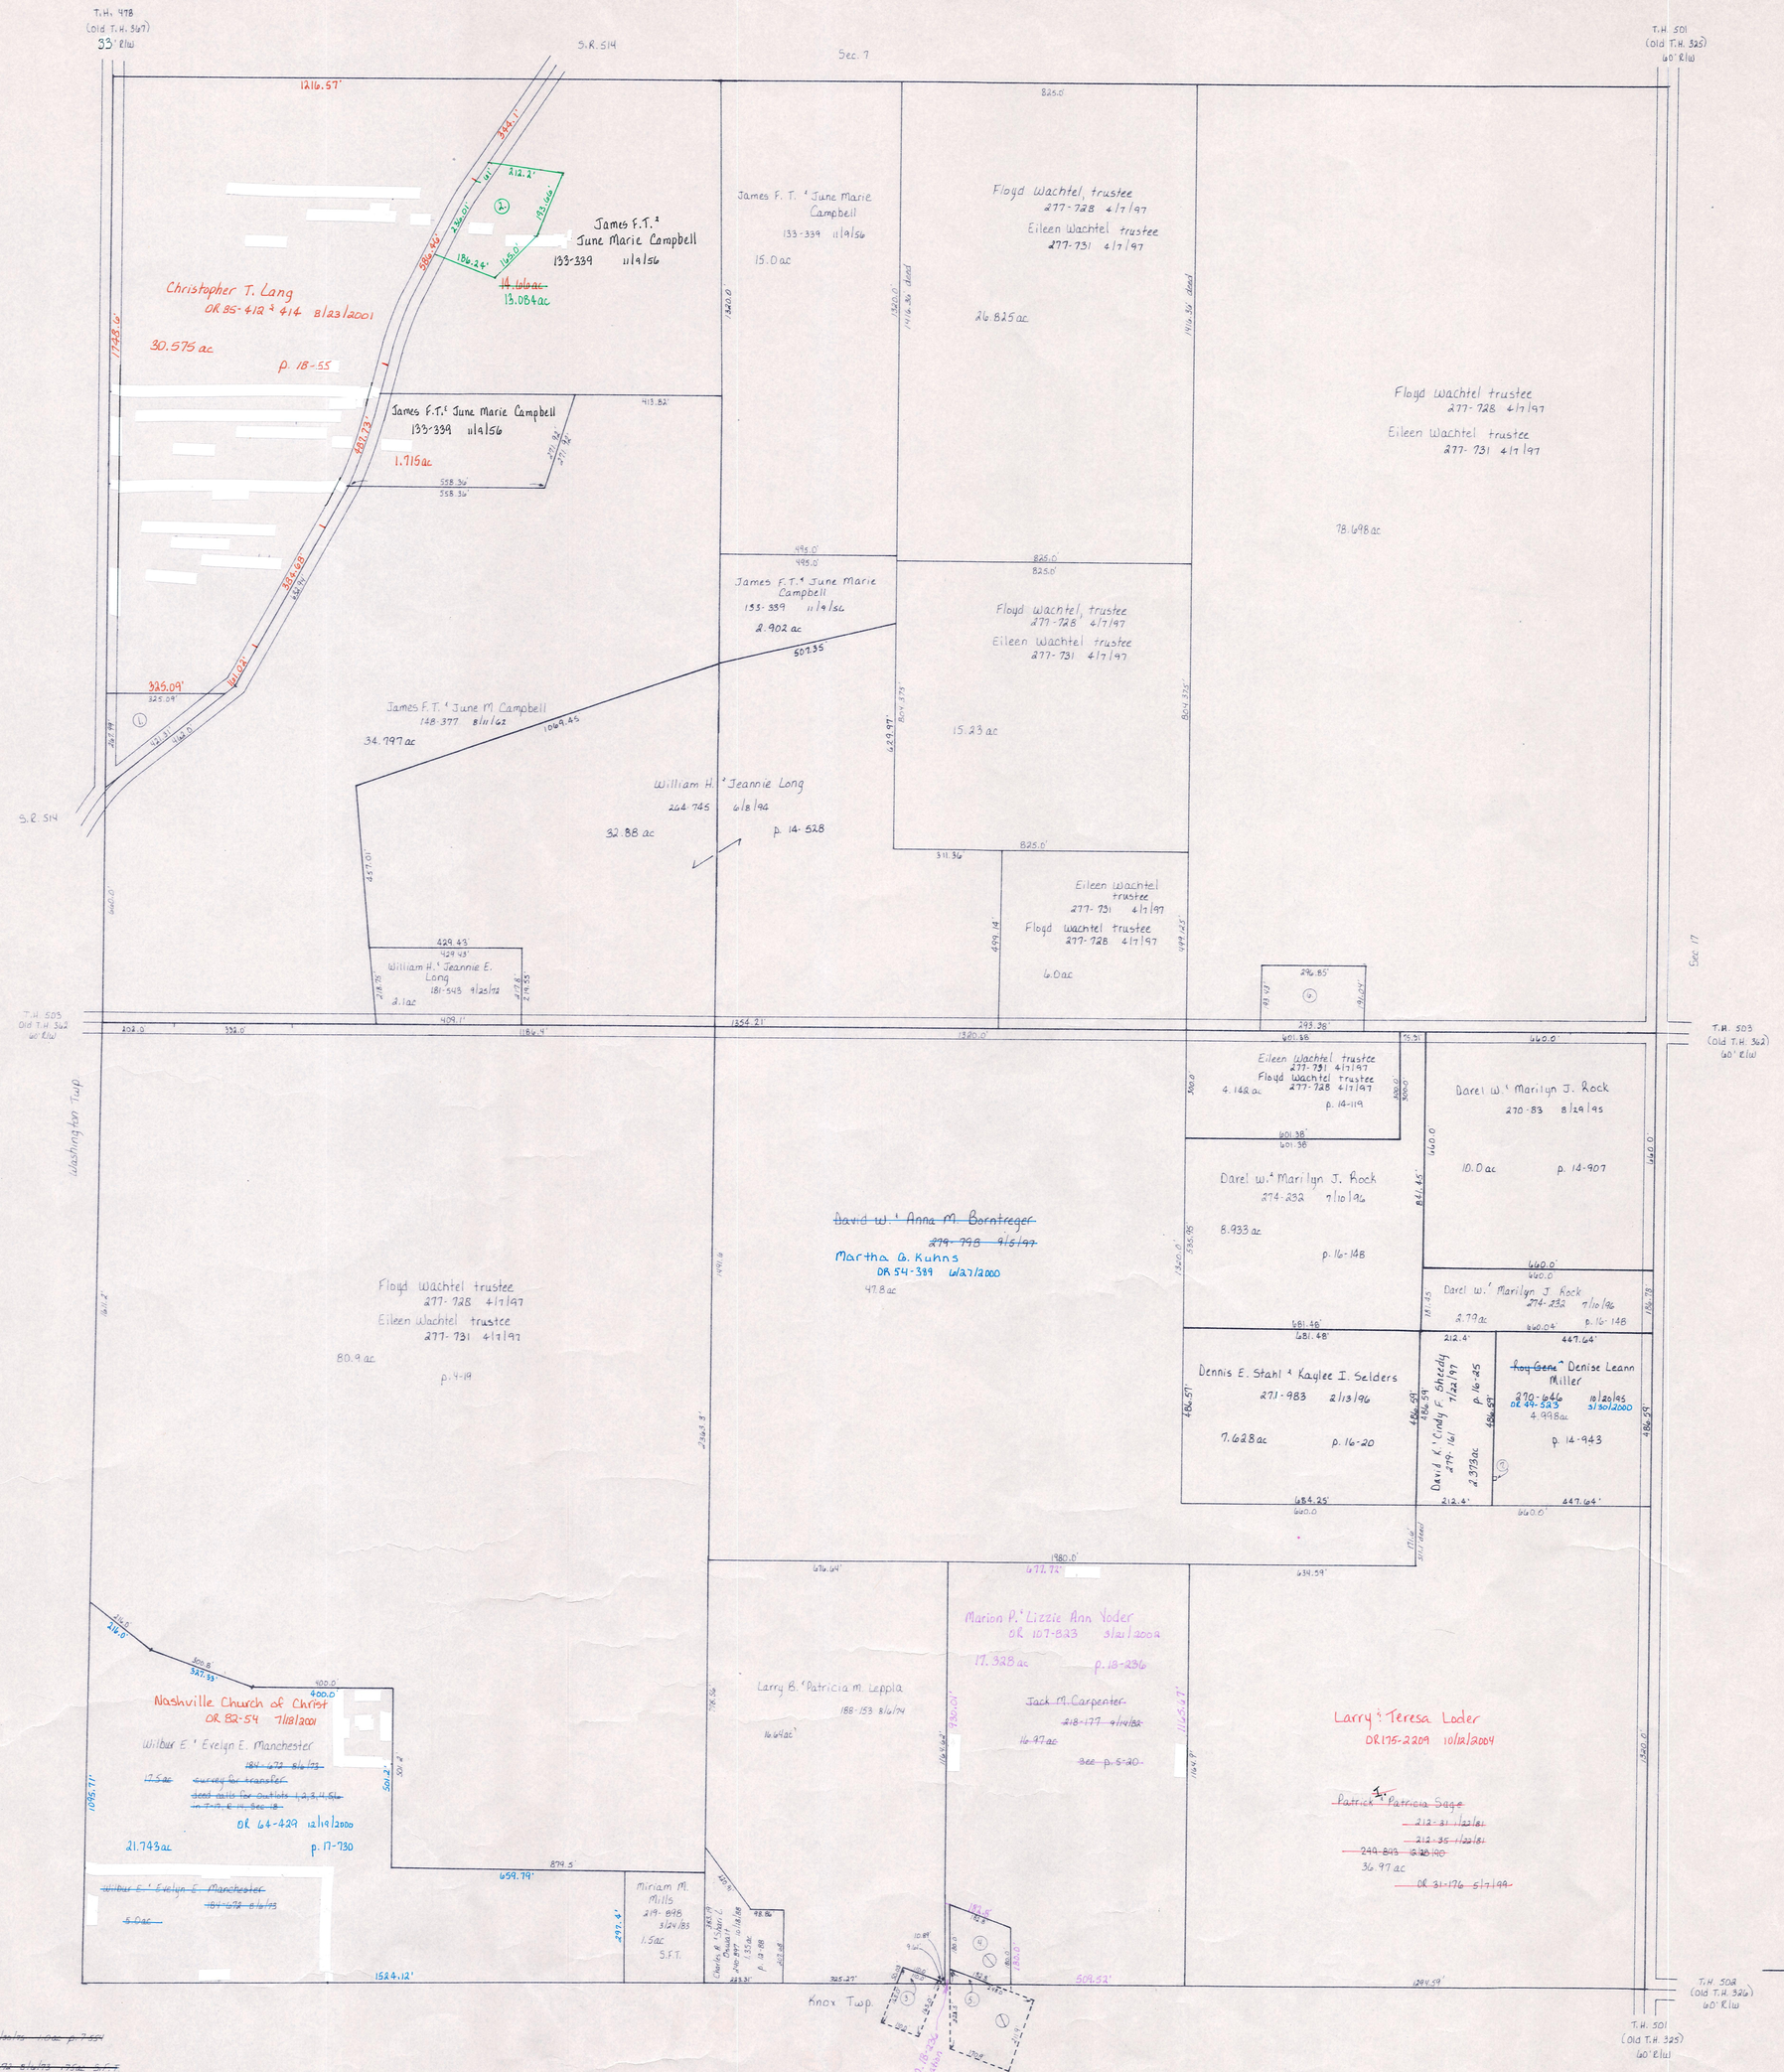

~~① James M. & Sharon L. Bennett 192-908 6/16/95 1.0 ac p. 7-551~~

~~② Wilbur E. & Evelyn E. Manchester 184-673 8/6/93 .75 ac S.F.T.~~

~~③ Larry & Patricia Leppla 188-153 8/6/94 p. 1 of 188-153 in Sec. 18 Knox Twp.~~

~~④ Bonnie Elizabeth & Robert D. Hazlett 218-371 6/16/87 .64 ac p. 1-3~~

~~⑤ ⑥ Bonnie Elizabeth & Robert D. Hazlett 218-371 6/16/87 p. 1 of 188-153 in Sec. 18 Knox Twp.~~

~~⑦ Eileen Wachtel 277-731 4/7/97 OR 77-676 8/25/82 .493 ac p. 10-507~~

~~⑧ David K. & Cindy F. Shtezdy OR 1-592 1/12/18 .50 ac p. 16-60~~

T-17, R-14, Sec. 18
RIPLEY TWP.

SCALE : 1" = 200'

LET IT BE KNOWN, THIS MAP HAS BEEN PREPARED AS A REFERENCE GUIDE TO PROPERTY OWNERSHIP. WE BELIEVE THIS INFORMATION TO BE CORRECT AND CURRENT, HOWEVER, IT IS NOT INTENDED FOR ANY LEGAL USE, WHETHER IT BE IN SALES, TRANSFERS, TRADES, LEASES OF ANY TYPE, ETC., AND DO NOT ACCEPT RESPONSIBILITY FOR ERRORS OF ANY NATURE OR OMISSIONS CONTAINED HEREIN.

RP-1