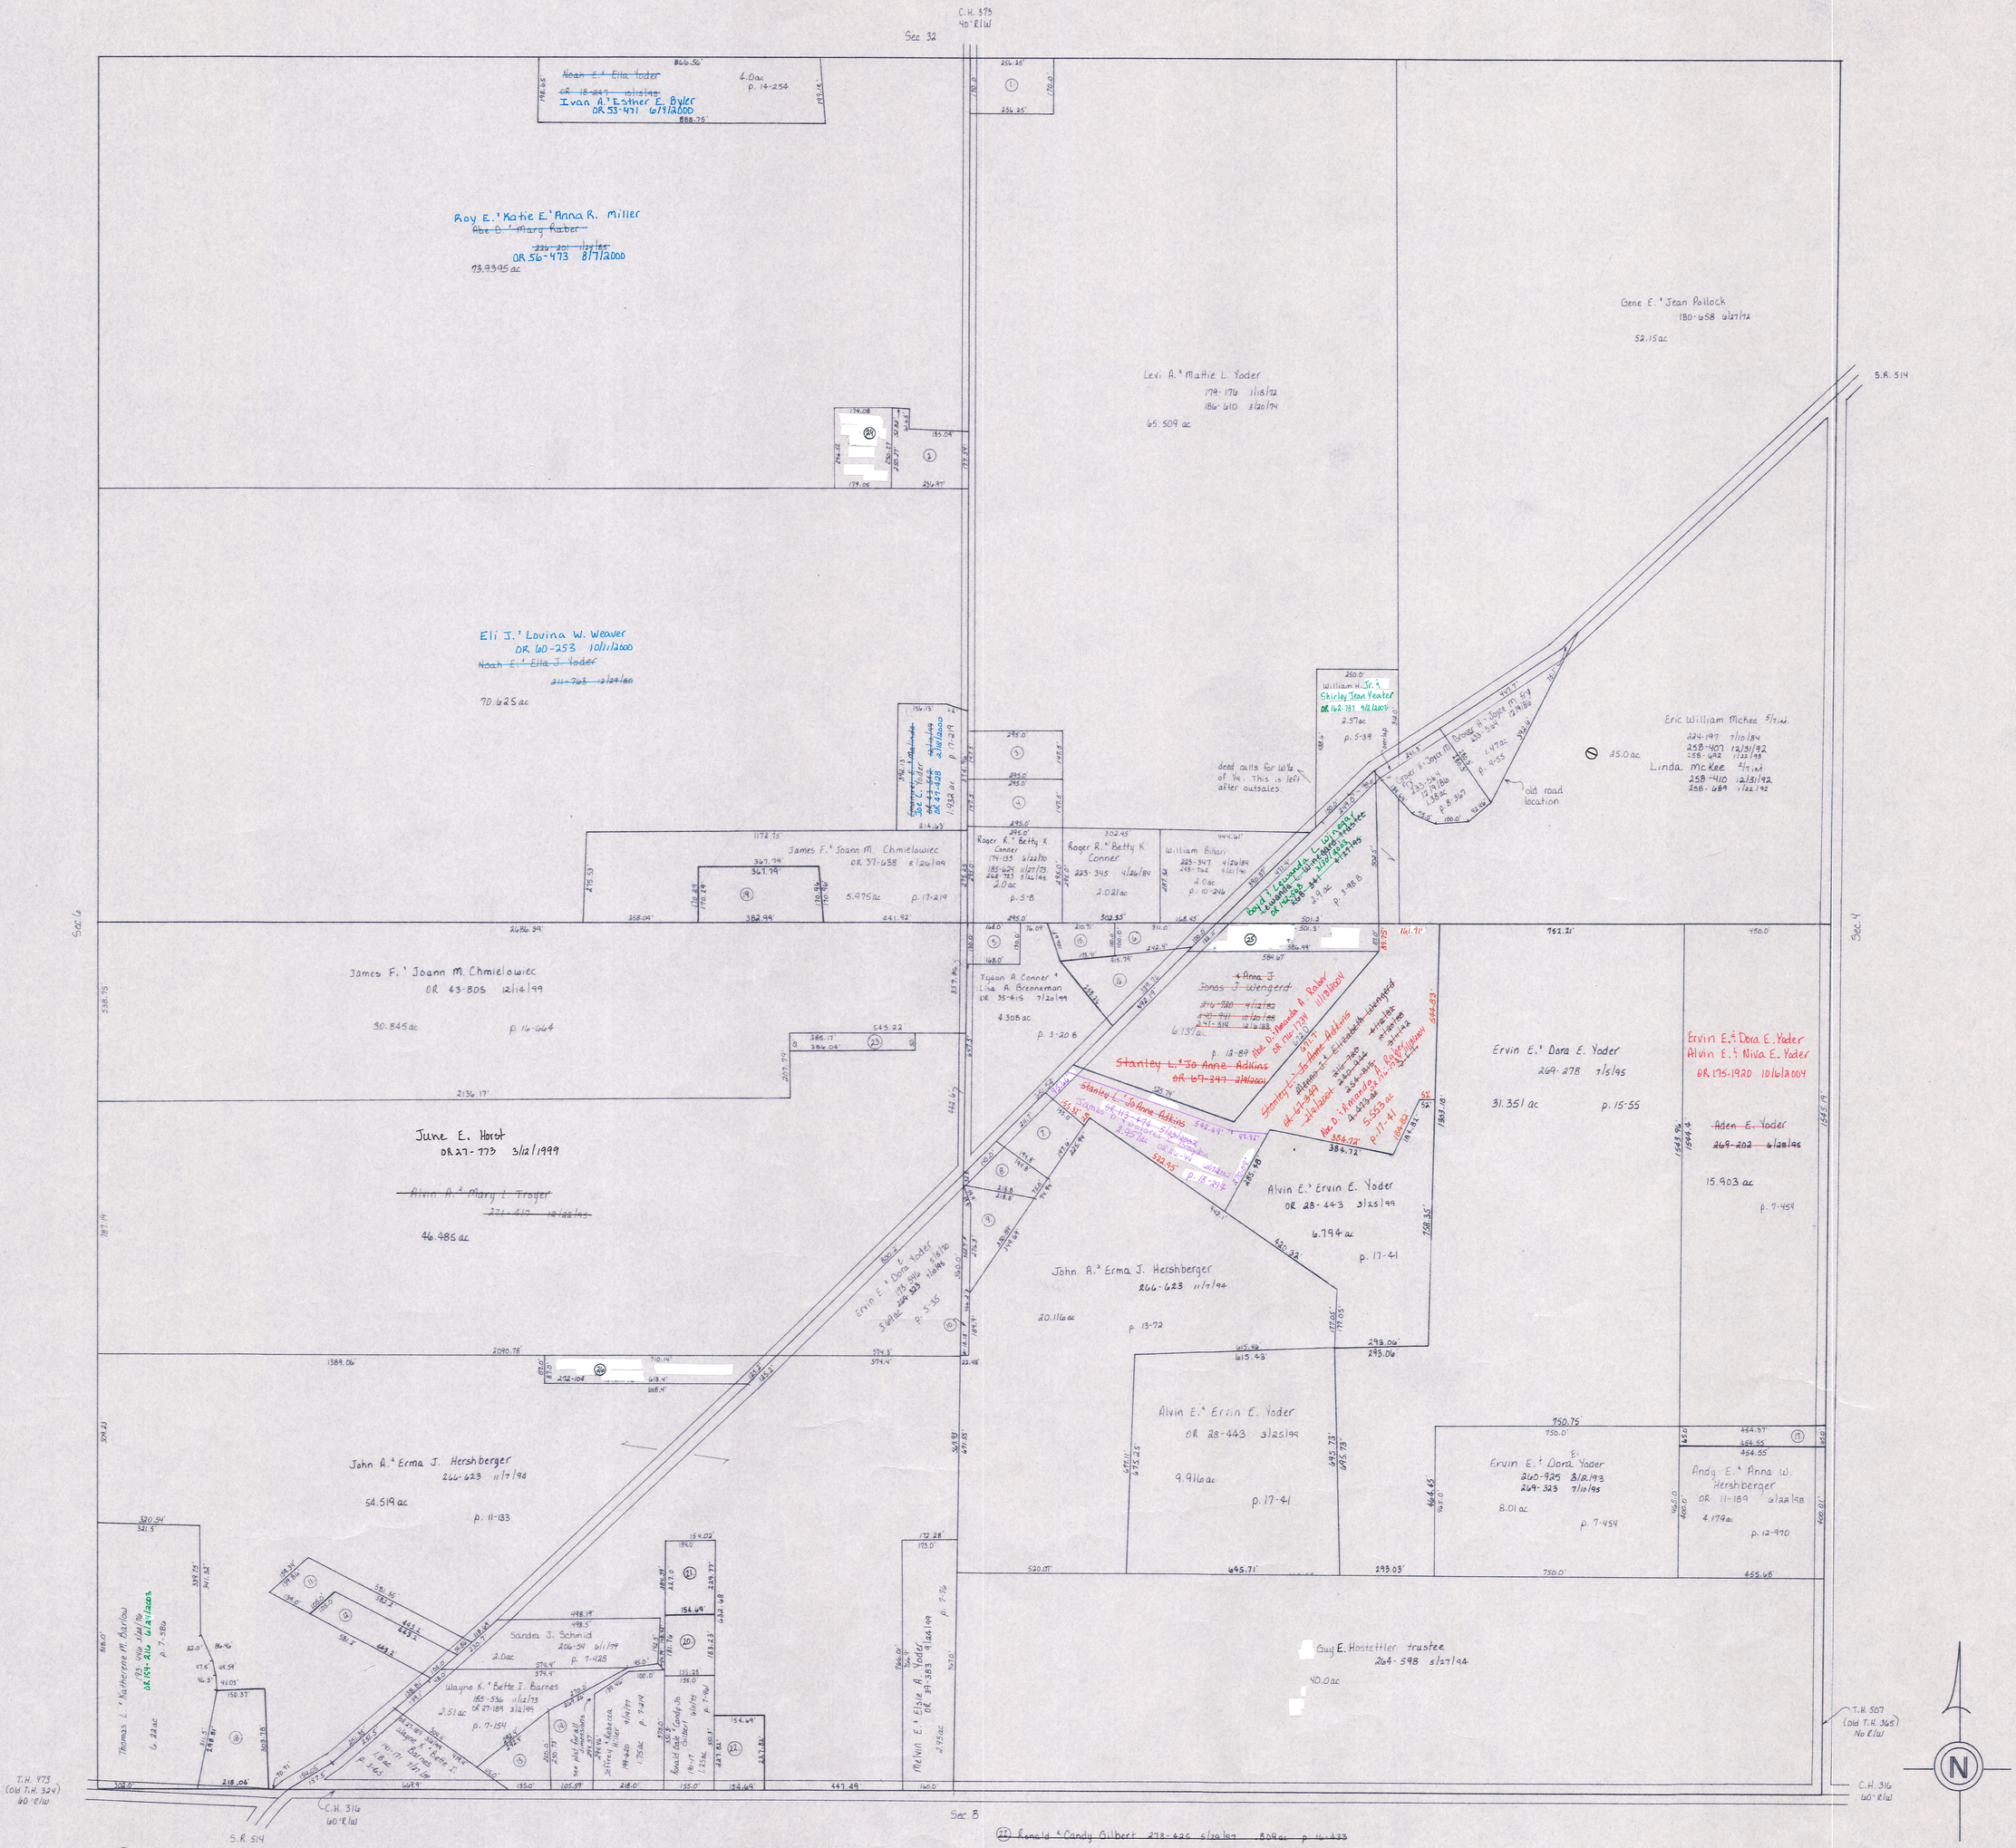

1. ~~Joe L. Yoder 270-776 11/1/85 1.0ac p. 10-116~~
2. ~~Dan D.' Lydia Raber 209-564 11/1/78 1.0ac p. 8-240~~
3. ~~K. Gregory Smith 248-497 3/6/89 1.0ac p. 5-8~~
4. ~~K. Gregory Smith 248-497 3/6/89 1.0ac p. 5-8~~
5. ~~Tyson A. Conner & Lisa A. Brenneman OR 35-615 7/20/99 .5ac p. 7-250~~
6. ~~David A.' Lydia Ann Raber OR 51-148 12/1/2000~~
7. ~~John A.' Edna L. Raber 248-426 3/26/85 .53ac p. 8-745~~
8. ~~Gerald D.' Veronica Faye Hostettler OR 49-141 3/26/2000~~
   ~~Eli J. Weaver OR 51-535 6/21/01 260-692 11/22/93 .83ac plat in file~~
   ~~Robert B.' Margaret A. Compton OR 52-354 11/1/2000~~
9. ~~Randy M.' Jane L. Martin 211-70 10/5/80 .56ac plat in file~~
10. ~~Randy M.' Jane L. Martin 211-70 10/5/80 .75ac p. 7-469~~
11. ~~Ervin E.' Dora E. Yoder 269-323 7/10/95 .21ac p. 7-469~~
12. ~~Barbara J. Karlan FKA Spitler 259-181 3/14/93 1.0ac~~
13. ~~Barbara J. Karlan FKA Spitler 259-181 3/14/93 1.0ac p. 7-80~~
14. ~~Donald.' Evelyn Barnes 174-358 2/5/70 .72ac p. 5-45~~
15. ~~Donald J.' Evelyn R. Barnes 223-805 11/1/84 .946ac p. 11-5~~
16. ~~David A.' Lydia Ann Raber OR 51-148 12/1/2000~~
17. ~~John A.' Edna L. Raber 248-426 3/26/85 .79ac p. 12-73~~
18. ~~David A.' Lydia Ann Raber OR 51-148 12/1/2000~~
19. ~~John A.' Edna L. Raber 266-623 11/7/94 1.006ac p. 12-932~~
20. ~~Ervin E.' Dora Yoder 260-925 8/12/93 .470ac p. 14-253~~
    ~~269-323 7/10/95~~
21. ~~Roman A.' Mary J. Hershberger 234-162 2/13/87 1.250ac p. 14-638~~
    ~~262-682 11/7/94~~
22. ~~James F.' Joann M. Chmielowiec OR 37-638 8/26/89 1.468ac p. 14-895~~
23. ~~Ronald.' Candy Gilbert 227-75 6/23/85 232-718 10/1/86 .649ac p. 10-625~~
24. ~~John A.' Erma J. Hershberger 278-423 5/29/97 8.09ac p. 16-433~~
25. ~~Ronald.' Candy Gilbert 278-425 5/29/97 8.09ac p. 16-433~~
26. ~~James F.' Joann M. Chmielowiec OR 43-805 12/16/99 .45ac p. 17-95~~

T-17, R-14, Sec. 5
RIPLEY TWP.

SCALE: 1" = 200'

LET IT BE KNOWN, THIS MAP HAS BEEN PREPARED AS A REFERENCE GUIDE TO PROPERTY OWNERSHIP. WE BELIEVE THIS INFORMATION TO BE CORRECT AND CURRENT, HOWEVER, IT IS NOT INTENDED FOR ANY LEGAL USE, WHETHER IT BE IN SALES, TRANSFERS, TRADES, LEASES OF ANY TYPE, ETC., AND DO NOT ACCEPT RESPONSIBILITY FOR ERRORS OF ANY NATURE OR OMISSIONS CONTAINED HEREIN.

RP-83